

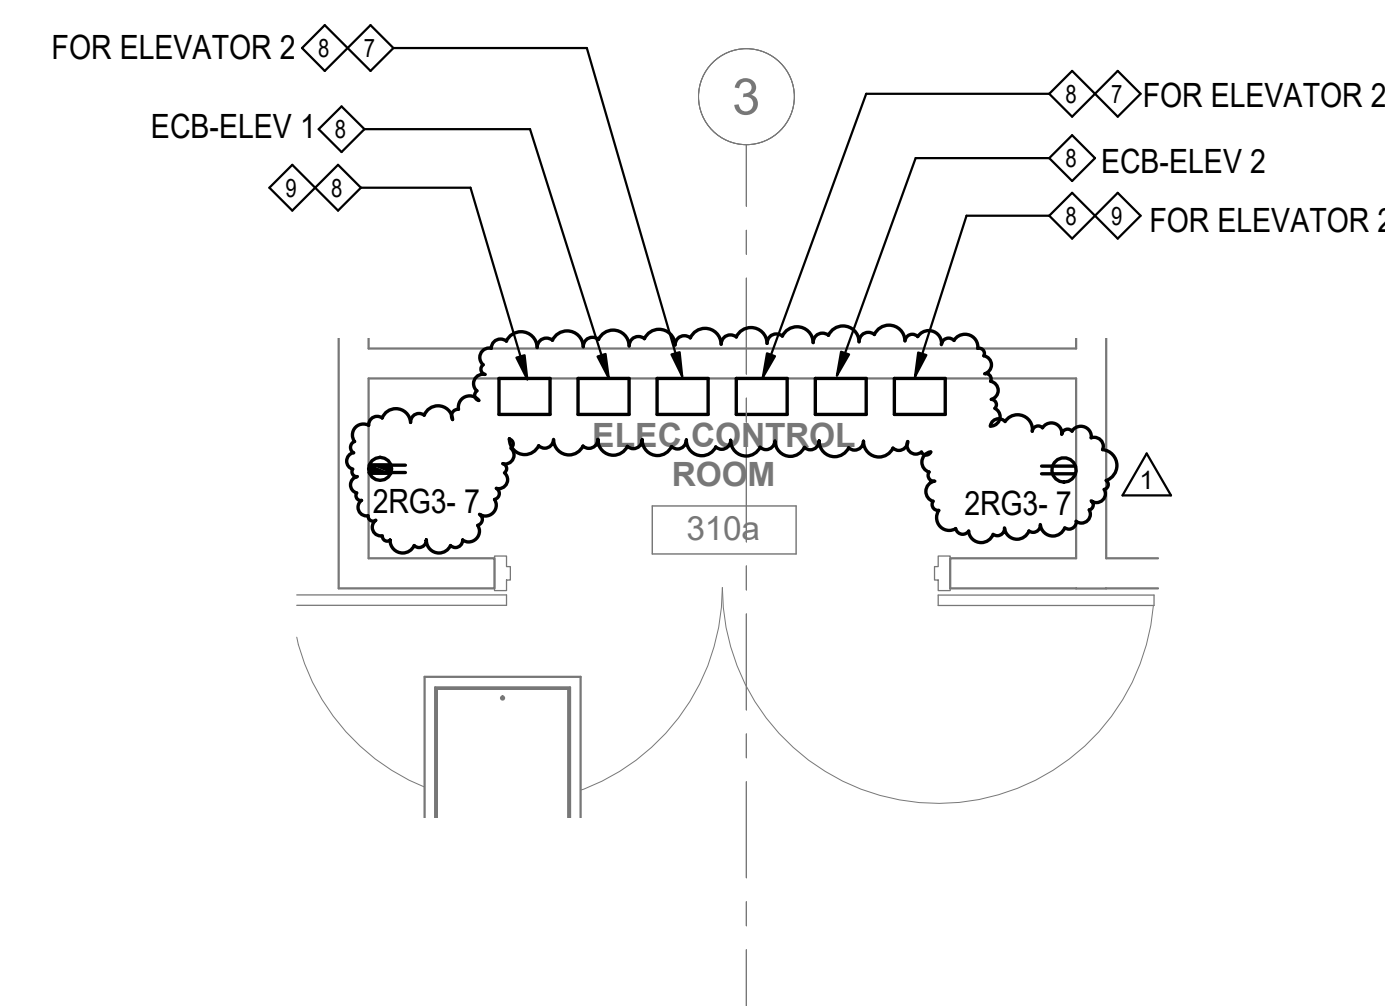
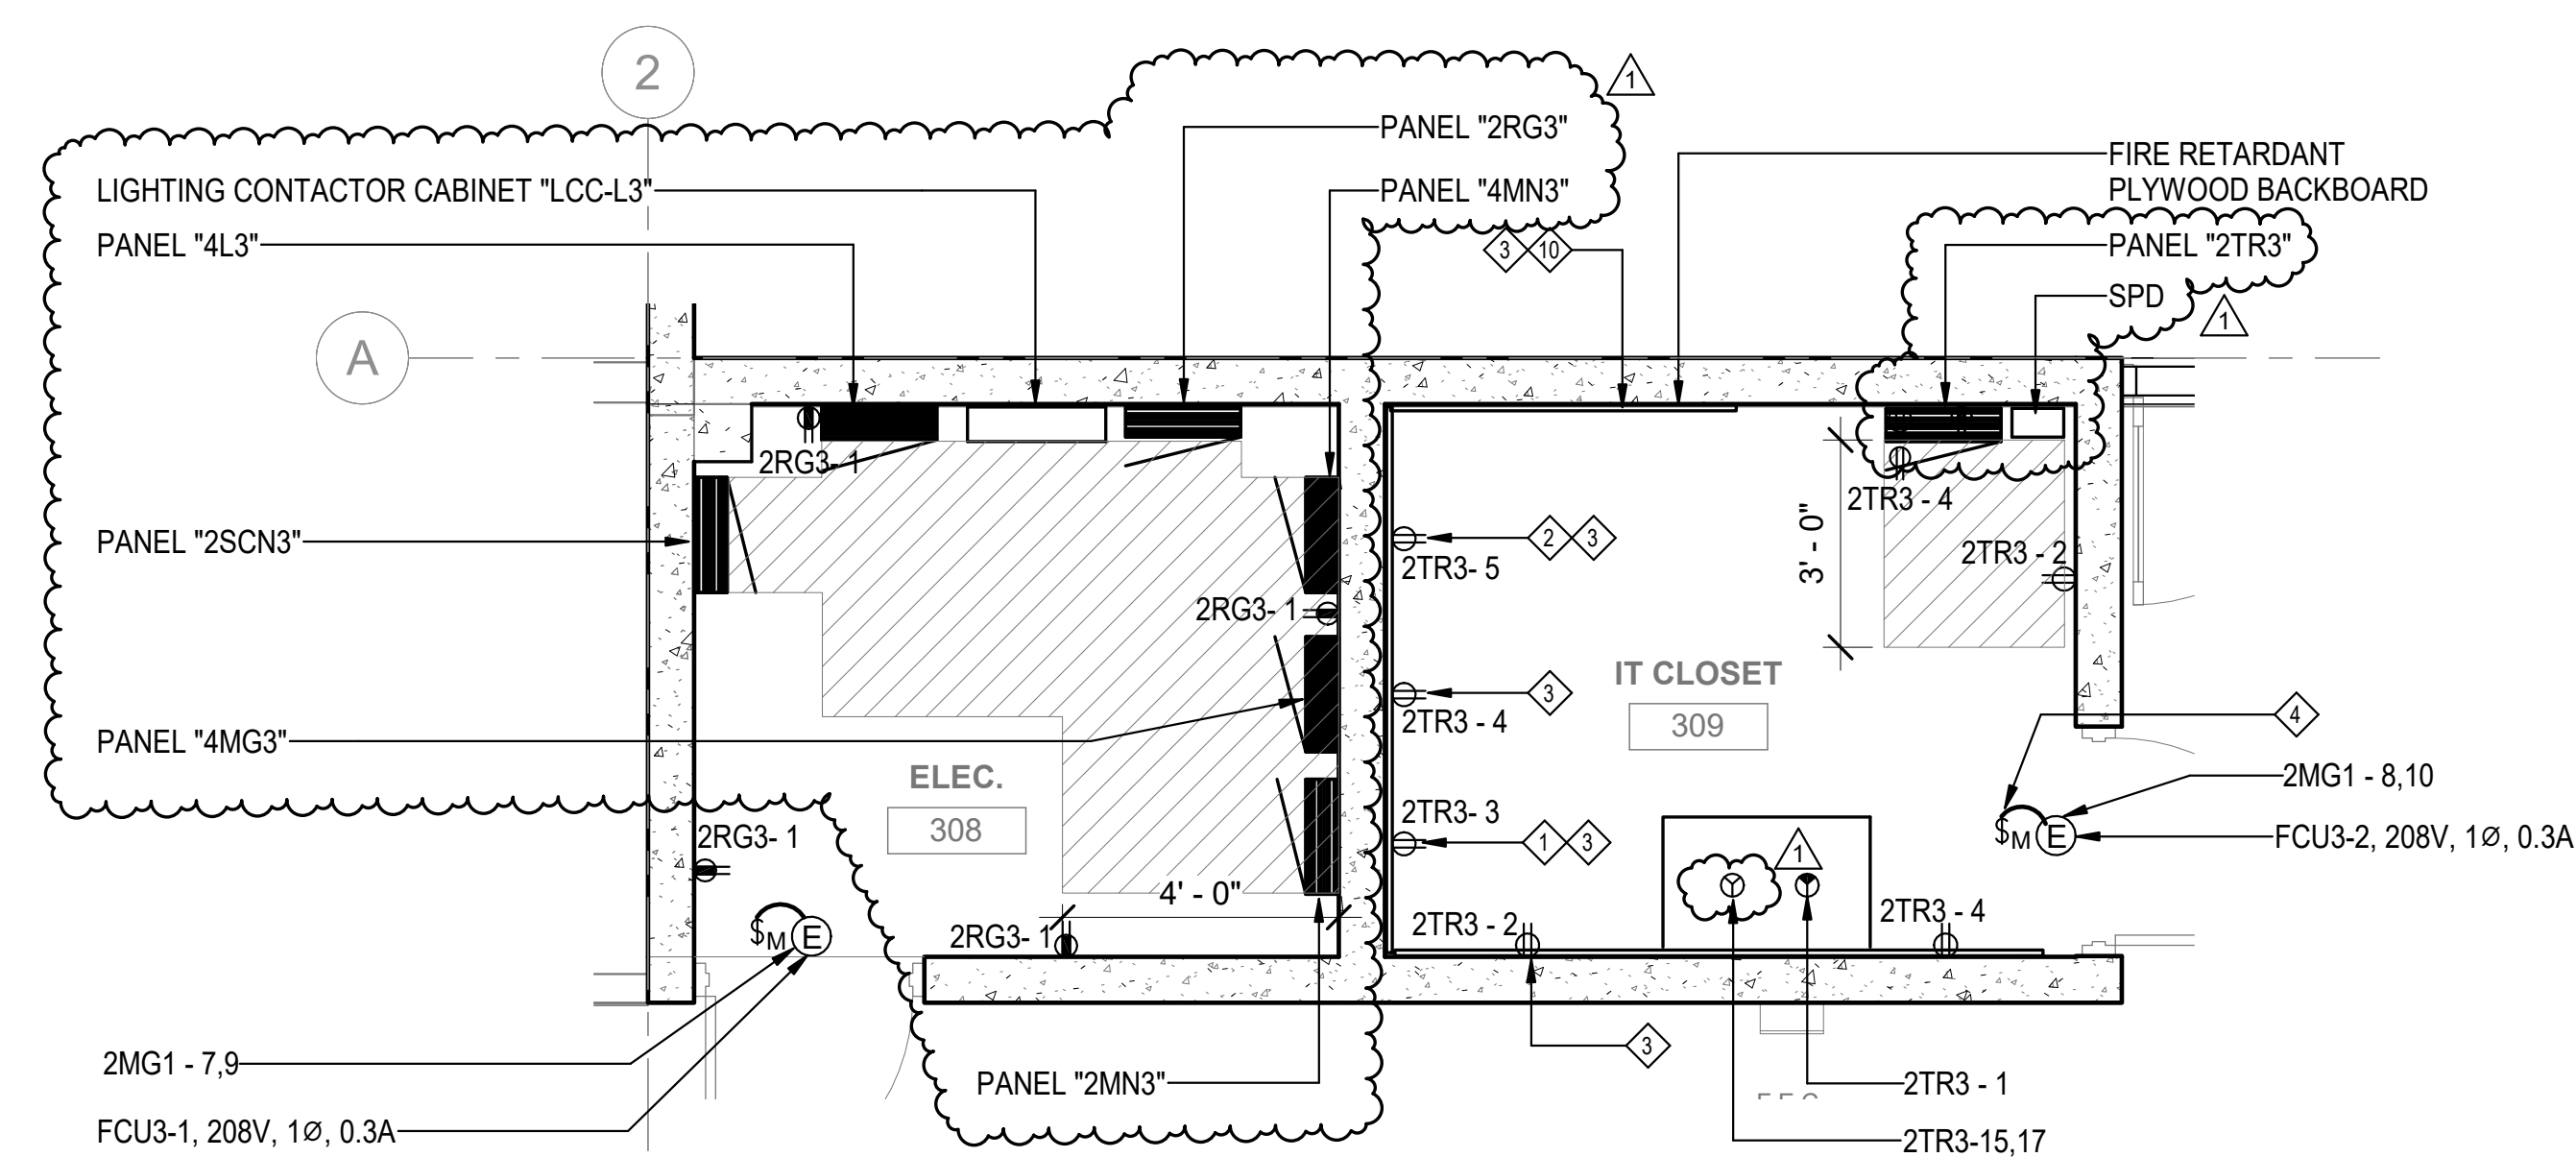


- ① ALL CIRCUITS SHALL BE CIRCUITED DEDICATED FACILITY PANEL. THIS DRAWINGS PROVIDES CIRCUIT NUMBER ONLY. REFER TO E8.3 TO E8.6 DRAWINGS FOR PANELBOARD SCHEDULES. AS BUILT DRAWINGS OF FLOOR PLANS SHALL REFLECT ACTUAL CIRCUITING PROVIDED BY THE CONTRACTOR.
- ② LAYOUT PROVIDED IS BASED ON THE PHYSICAL DIMENSIONS OF ELECTRICAL EQUIPMENT USED AS THE BASIS OF DESIGN. SUBMIT SHOP DRAWING INDICATING FINAL LAYOUT OF EQUIPMENT IN THE ELECTRICAL TELECOM ROOMS. DRAWING MUST BE BASED ON ACTUAL DIMENSIONS OF THE APPROVED EQUIPMENT. ENSURE THAT NEC REQUIRED CLEARANCES ARE MET FOR ACTUAL EQUIPMENT INSTALLED FOR THE PROJECT. SUBMIT DIMENSIONED PLANS, SECTIONS AND ELEVATIONS SHOWING MINIMUM CLEARANCES FOR ALL EQUIPMENT. SHOP DRAWINGS MUST BE CERTIFIED BY A LICENSED PROFESSIONAL ELECTRICAL ENGINEER OR MASTER ELECTRICIAN.
- ③ SHADE INDICATES THE REQUIRED WORKING CLEARANCE OF THE EQUIPMENT.
- ④ INSTALL SPD CONDUITS WITHOUT BEND AN AS SHORT AS POSSIBLE.
- ⑤ SHADE INDICATES THE REQUIRED WORKING CLEARANCE OF THE EQUIPMENT.

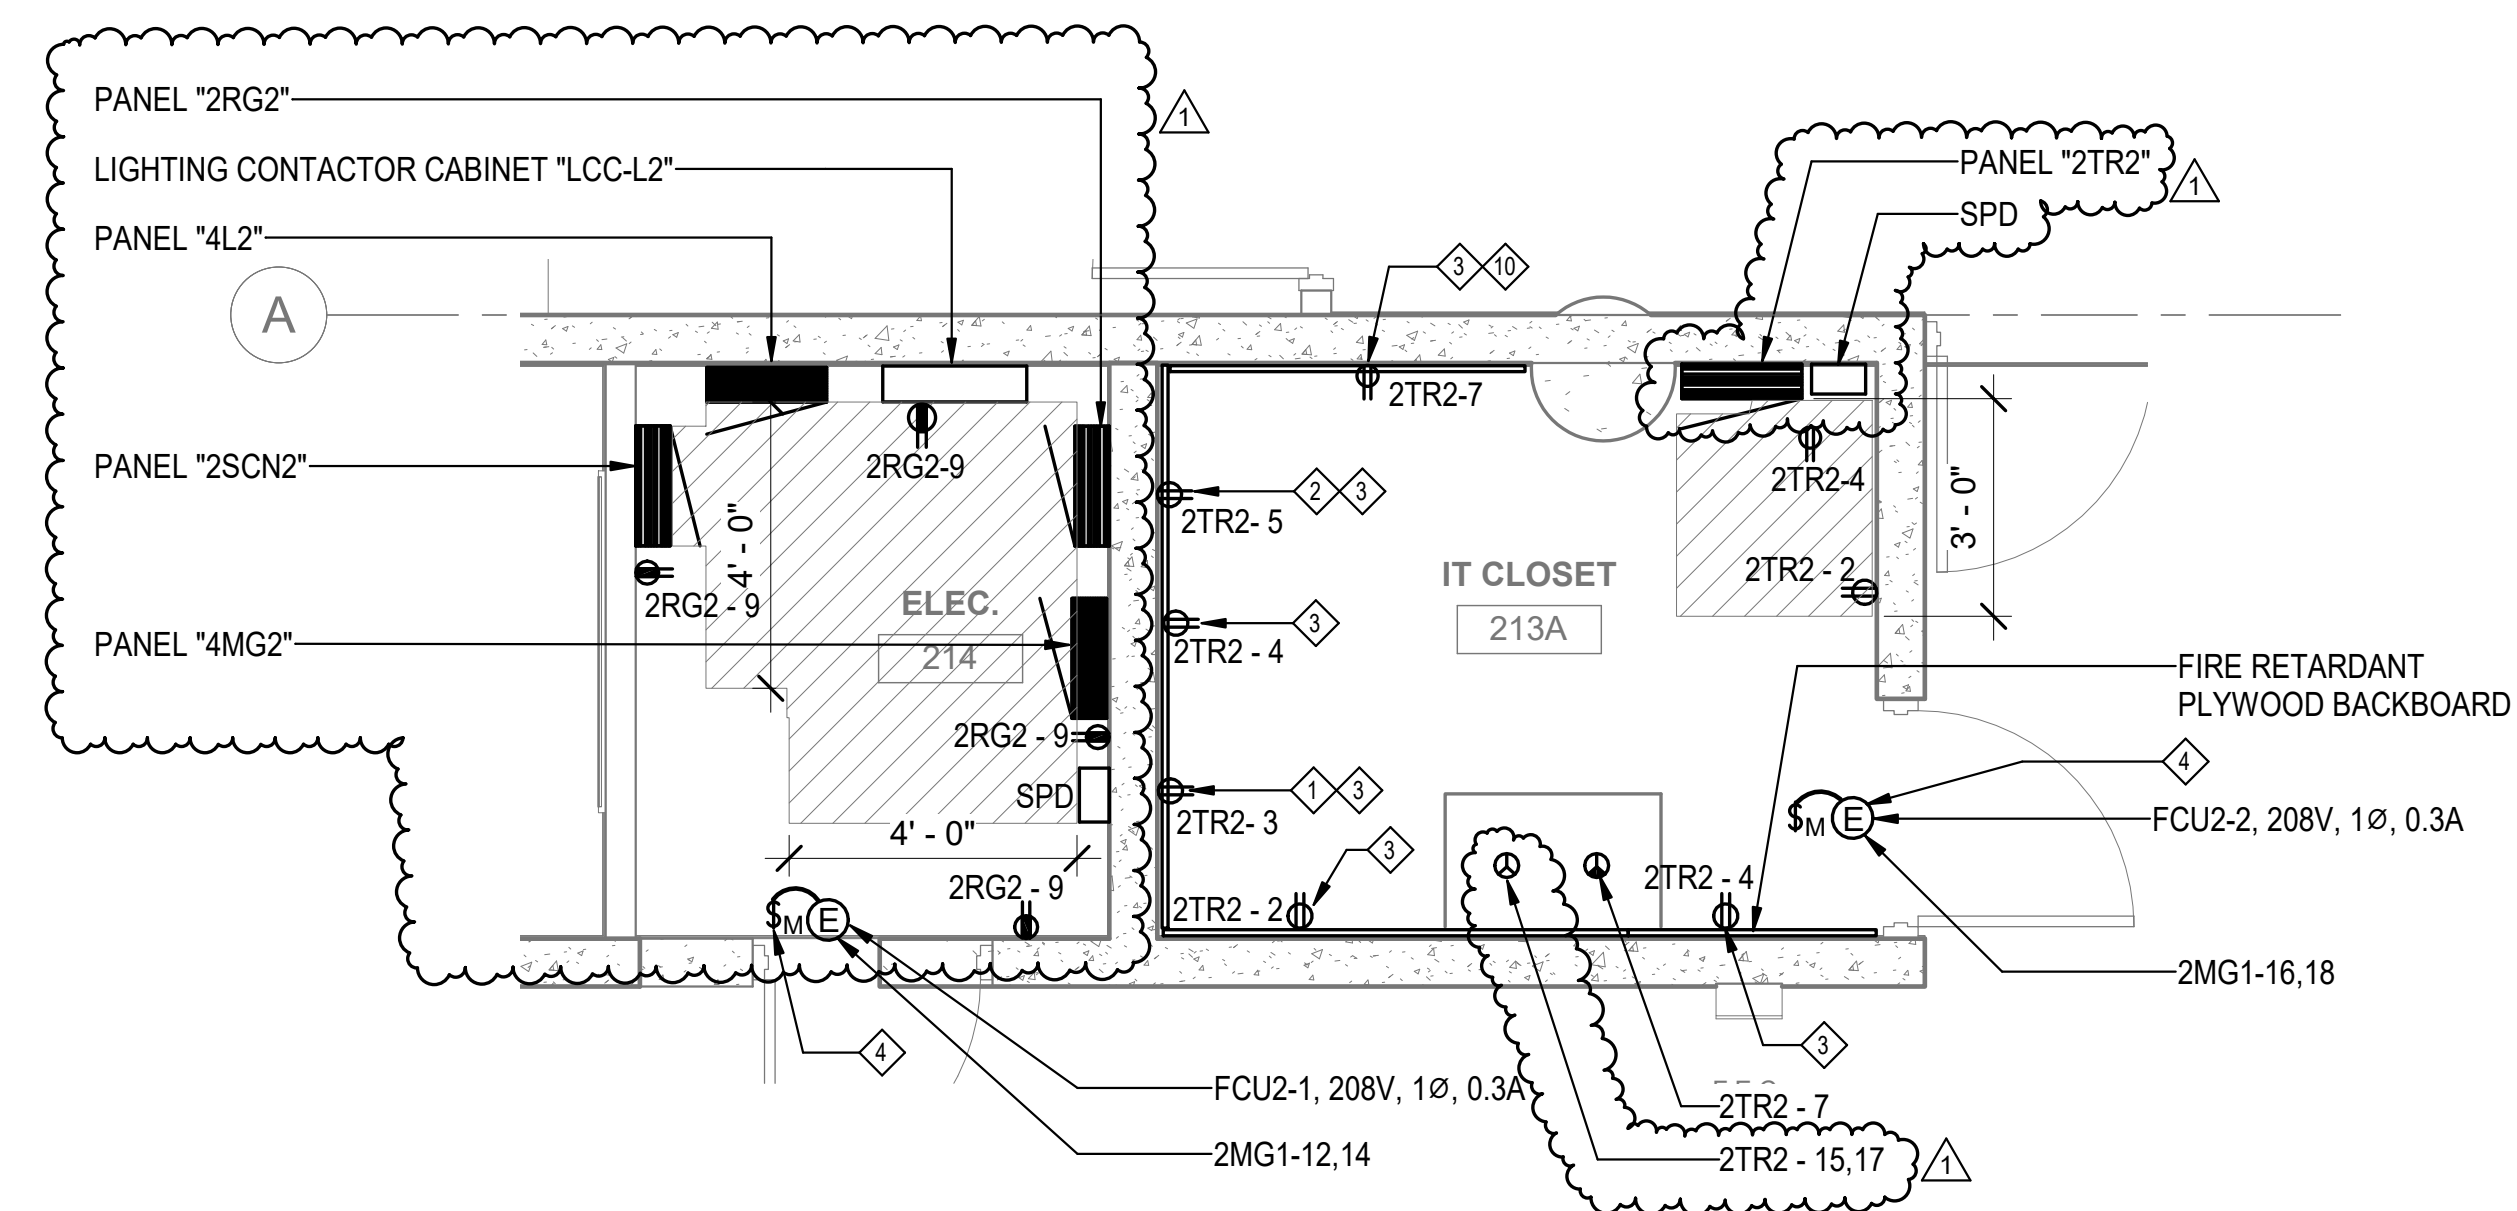

- NOTES: APPLICABLE TO ENTIRE SHEET

- 1 RECEPTACLE FOR ESS.
- 2 RECEPTACLE FOR CCTV.
- 3 INSTALL RECEPTACLE FLUSH MOUNTED ON TELECOM BACKBOARD.
- 4 MOUNT ADJACENT TO EQUIPMENT. COORDINATE EXACT LOCATION WITH THE EQUIPMENT INSTALLATION.
- 5 MOUNT ABOVE DRY TYPE TRANSFORMER "TSCN1"
- 6 MOUNT ABOVE PANELBOARD
- 7 ECB FOR CAR LIGHTS, CAR TOP RECEPTACLE, AUXILIARY LIGHTING POWER SOURCE AND VENTILATION.
- 8 VERIFY/COORDINATE FINAL RATING WITH ELEVATOR SUPPLIER AND ADJUST RATINGS AND ELECTRICAL CONNECTIONS (ECB, CONDUIT WIRING) ACCORDINGLY. PROVIDE SHUNT TRIP.
- 9 WALL MOUNTED ABOVE DRY TYPE TRANSFORMER "TSCN1". PROVIDE 2'-0" SEPARATION AND MOUNTING SUPPORT AS NEEDED.
- 10 RECEPTACLE FOR FA SYSTEM.
- 11 PROVIDE WALL-MOUNTING BRACKET KITS, FOR REVIEW AND APPROVAL.

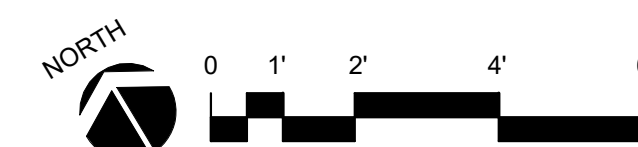

IF SHEET IS LESS THAN 24" X 36"
REDUCED PRINT - USE GRAPHIC SCALES


[illegible]TRMA 

Taniguchi Ruth Makio Architects
100 Cliff Business Center, P.O. Box EA, Agana, GU 96911
Tel.: (671) 475-8772 • Fax.: (671) 472-338

Architecture
Planning
Interior Design



EMCE · Consulting Engineers
SUITE 201, 133 ANTONIA COURT
P.O. BOX 9940 TAMUNING, GUAM 96931
671. 649-0166/7 Phone
671. 646-EMCE (3623) Fax

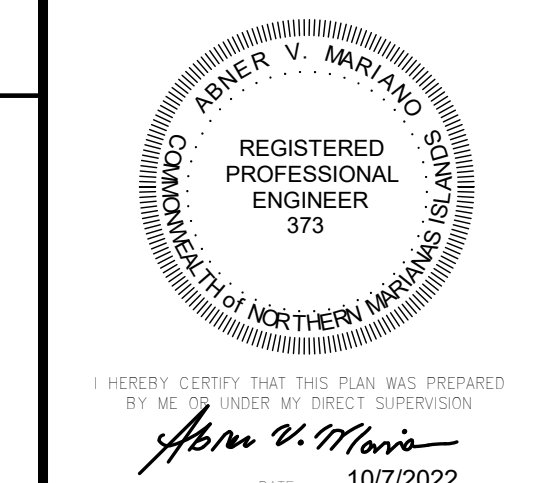

Project:	NMC
	PACKAGE 1: STUDENT CENTER BUILDING

Title:

ELECTRICAL
ENLARGED PLANS -
SHEET 1

Designed:		JF/LB
Drawn:		NP/RS
Checked:		AM/IA
Supv:		AM
Scale:		AS INDICATED
Date:		10/07/2022
Project No. 24-22-493	File	
Drawing No.		

E7.1

Sheet No. _____ of _____