

REVISIONS		
No.	Description	Date
1	ADDENDUM 1	12/6/22
2	ADDENDUM 2	01/16/22



Taniguchi Ruth Makio Architects  
100 Cliff Business Center, P.O. Box EA, Agaña, GU 96910  
Tel.: (671) 475-8772 • Fax.: (671) 472-3381

Architecture  
Planning  
Interior Design



EMCE Consulting Engineers  
SUITE 201, 133 ANTONIA COURT  
P.O. BOX 9940 TAMUNING, GUAM 96931  
671. 649-0166/7 Phone  
671. 646-EMCE (3623) Fax



Project:  
  
NMC  
PACKAGE 1: STUDENT  
CENTER BUILDING

Title:  
  
SECOND FLOOR  
LIGHTING PLAN -  
SHEET 1  
  
CONSTRUCTION  
DOCUMENTS

Designed: JF/LB  
Drawn: NP/RS  
Checked: AM/IA  
Supv: AM  
Scale: AS INDICATED  
Date: 10/07/2022  
Project No. 24-22-493  
Drawing No.


E4.2.1  
Sheet No. of

GENERAL NOTES: (LIST OF NOTES APPLICABLE TO ALL E4.X.X SERIES DRAWINGS.  
NOT ALL NOTES MAY BE USED ON EACH INDIVIDUAL E4.X.X  
DRAWINGS)

- ALL CIRCUITS SHALL BE CIRCUITED TO DEDICATED FACILITY PANEL.  
THIS DRAWING PROVIDES CIRCUIT NUMBER ONLY. REFER TO E8.4 TO E8.8  
DRAWINGS FOR PANELBOARD SCHEDULES. AS BUILT DRAWINGS OF FLOOR  
PLANS SHALL REFLECT ACTUAL CIRCUITING PROVIDED BY THE CONTRACTOR.
- COORDINATE FINAL LOCATION OF LIGHT FIXTURES IN THE MECHANICAL ROOMS  
WITH EQUIPMENT, DUCTWORK AND PIPING. ADJUST LOCATIONS AS NECESSARY  
TO ENSURE A COORDINATED INSTALLATION WHILE ACHIEVING ILLUMINATION  
REQUIREMENT WITH IN THE SPACE.

NOTES: (LIST OF NOTES APPLICABLE TO ALL E4.X.X SERIES DRAWINGS.  
NOT ALL NOTES MAY BE USED ON EACH INDIVIDUAL E4.X.X DRAWINGS)

- PENDANT MOUNT AT 7'-0" AFF.
- PENDANT MOUNT AT 8'-0" AFF.
- PENDANT MOUNT AT 8'-6" AFF.
- PENDANT MOUNT AT 9'-0" AFF.
- PENDANT MOUNT AT 10'-0" AFF.
- PENDANT MOUNT AT 20'-0" AFF.
- PENDANT MOUNT AT 24'-0" AFF.
- WALL MOUNT AT 8'-0" AFF.
- WALL MOUNT AT 25'-0" AFF.
- PENDANT MOUNT AT 23'-0" AFF.
- PENDANT MOUNT AT 19'-0" AFF.
- PENDANT MOUNT AT 21'-0" AFF.
- PENDANT MOUNT AT 22'-0" AFF.
- WALL MOUNT AT 10'-0" AFF.
- WALL MOUNT AT 13'-0" AFF.

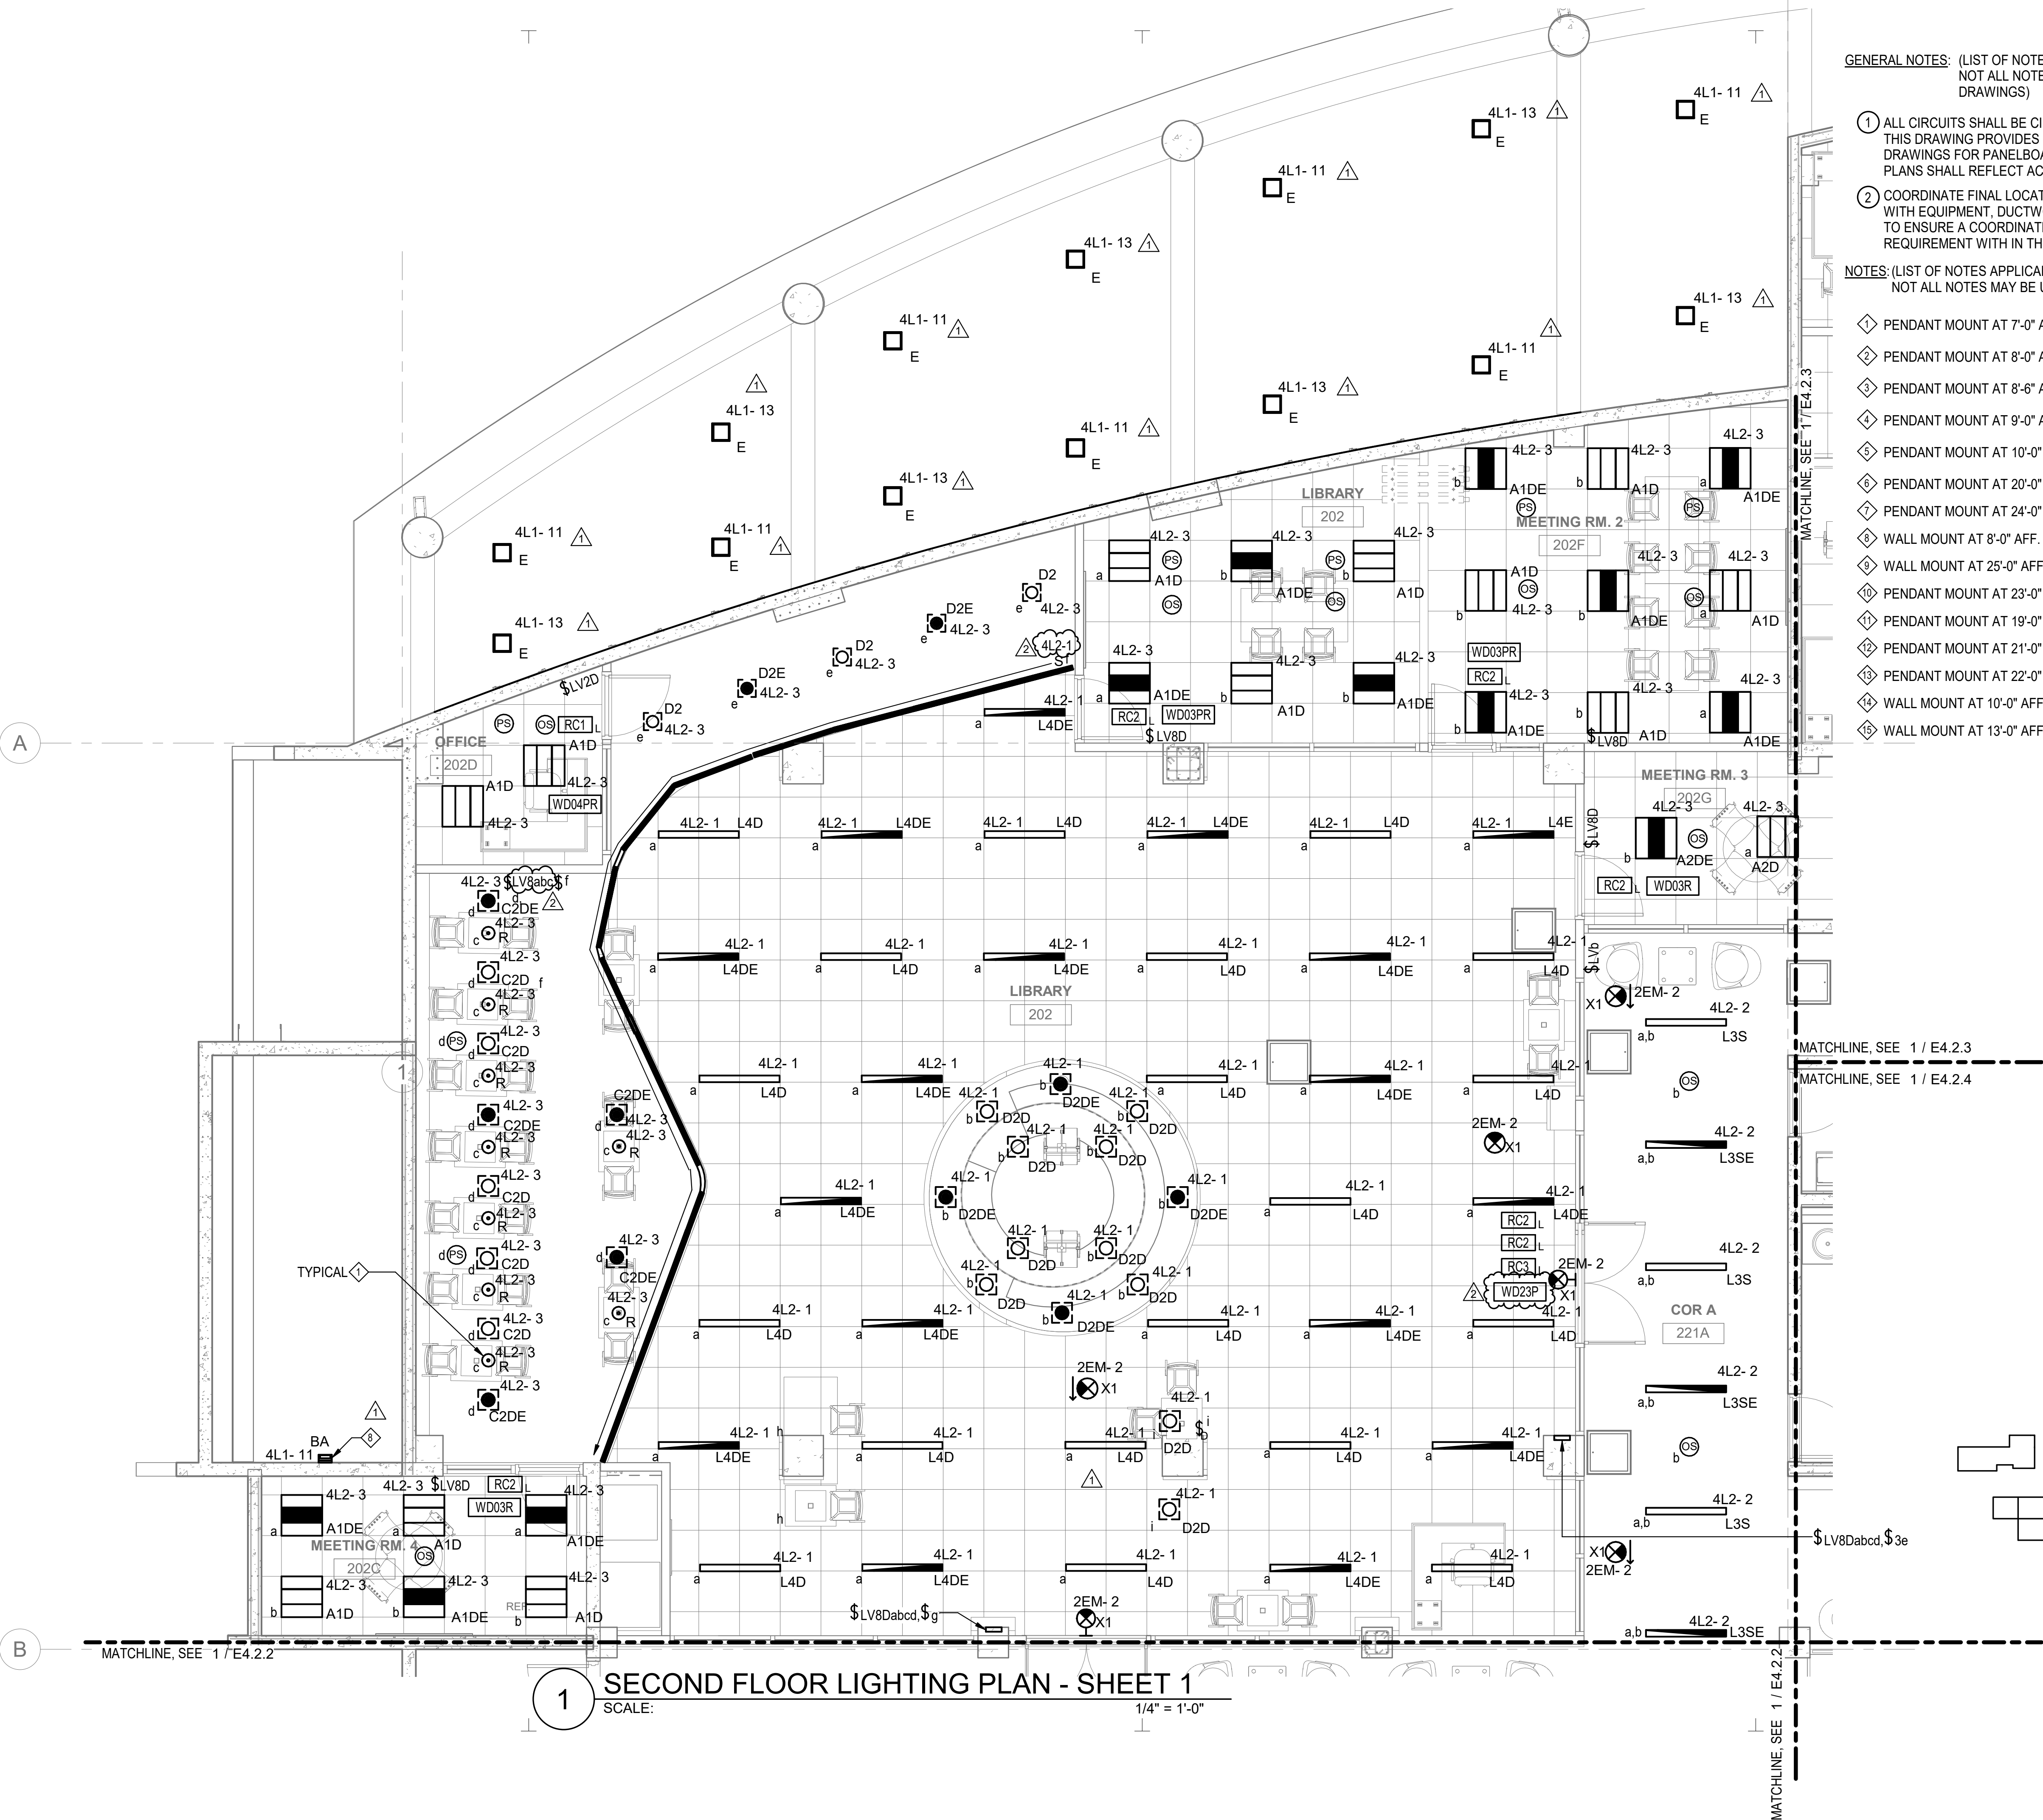

1 SECOND FLOOR LIGHTING PLAN - SHEET 1  
SCALE: 1/4" = 1'-0"