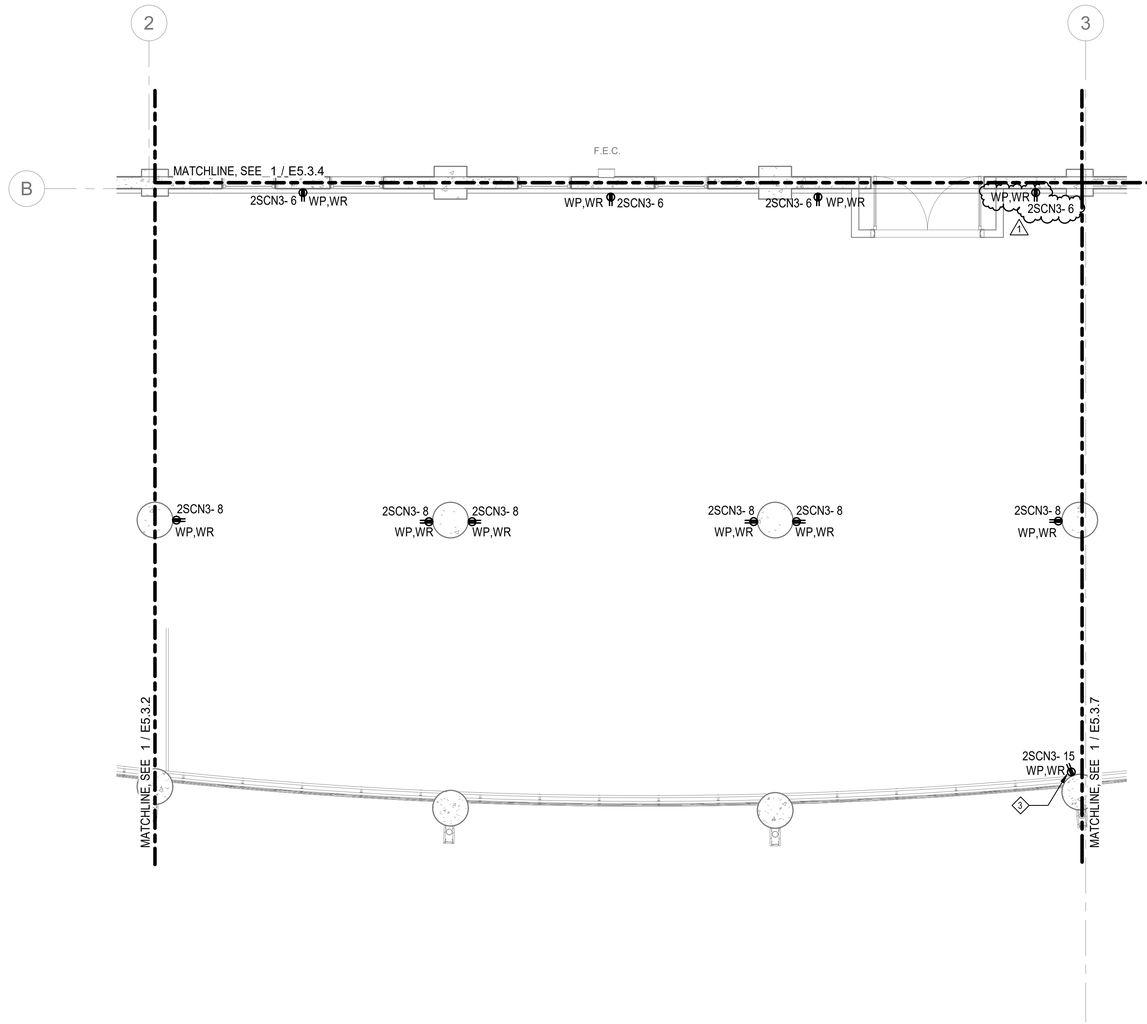

GENERAL NOTE: (LIST OF NOTES APPLICABLE TO ALL E5.X.X SERIES. NOT ALL NOTES MAY BE USED ON EACH INDIVIDUAL E5.X.X DRAWINGS)

(1) ALL CIRCUITS SHALL BE CIRCUITED TO DEDICATED FACILITY PANEL. THIS DRAWINGS PROVIDES CIRCUIT NUMBER ONLY. REFER TO E8.4 TO E8.8 DRAWINGS FOR PANELBOARD SCHEDULES. AS BUILT DRAWINGS OF FLOOR PLANS SHALL REFLECT ACTUAL CIRCUITING PROVIDED BY THE CONTRACTOR.

NOTES: (LIST OF NOTES APPLICABLE TO ALL E5.X.X SERIES. NOT ALL NOTES MAY BE USED ON EACH INDIVIDUAL E5.X.X DRAWINGS)

1. STRATEGICALLY LOCATE DEVICE SO THEY ARE INSTALLED BEHIND THE TV MONITOR (HIDDEN FROM VIEW) COORDINATE WITH EQUIPMENT INSTALLATION.
2. MOUNT 8" ABOVE COUNTER OR SINK.
3. MOUNT ADJACENT TO EQUIPMENT.
4. MOUNT 2" ABOVE COUNTERTOP TO BOTTOM OF POWER OUTLET.
5. MOUNTED INSIDE DDC CABINET.

1 THIRD FLOOR POWER PLAN - SHEET 5

SCALE: 1/4" = 1'-0"

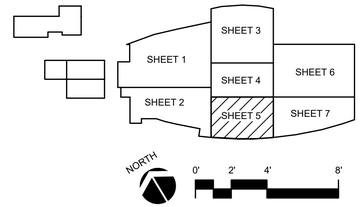

IF SHEET IS LESS THAN 24" X 36" REDUCED PRINT – USE GRAPHIC SCALES

REVISIONS		
No.	Description	Date
1	ADDENDUM 1	12/6/22

TRMA
Taniguchi Ruth Makio Architects
100 Cliff Business Center, P.O. Box EA, Agana, GU 96910
Tel.: (671) 475-8772 • Fax.: (671) 472-3381

Architecture
Planning
Interior Design

EMCE - Consulting Engineers
SUITE 201, 133 ANTONIA COURT
P.O. BOX 9940 TAMUNING, GUAM 96931
671. 649-0166/7 Phone
671. 646-EMCE (3623) Fax

ABNER V. MARIANO
REGISTERED PROFESSIONAL ENGINEER
373
COMMONWEALTH of NORTHERN MARIANAS ISLANDS

I HEREBY CERTIFY THAT THIS PLAN WAS PREPARED BY ME OR UNDER MY DIRECT SUPERVISION

DATE: 10/7/2022

Project:

NMC

PACKAGE 1: STUDENT CENTER BUILDING

Title:

THIRD FLOOR POWER PLAN - SHEET 5

CONSTRUCTION DOCUMENTS

Designed:	JF/LB
Drawn:	NP/RS
Checked:	AM/IA
Supv:	AM
Scale:	AS INDICATED
Date:	10/07/2022
Project No. 24-22-493	File

Drawing No.

E5.3.5

Sheet No._____ of _____